


SURVEY RECORD DRAWING  
Lot 100  
Boulevard Addition  
Lincoln, NE  
Sec 30 T10N R7E

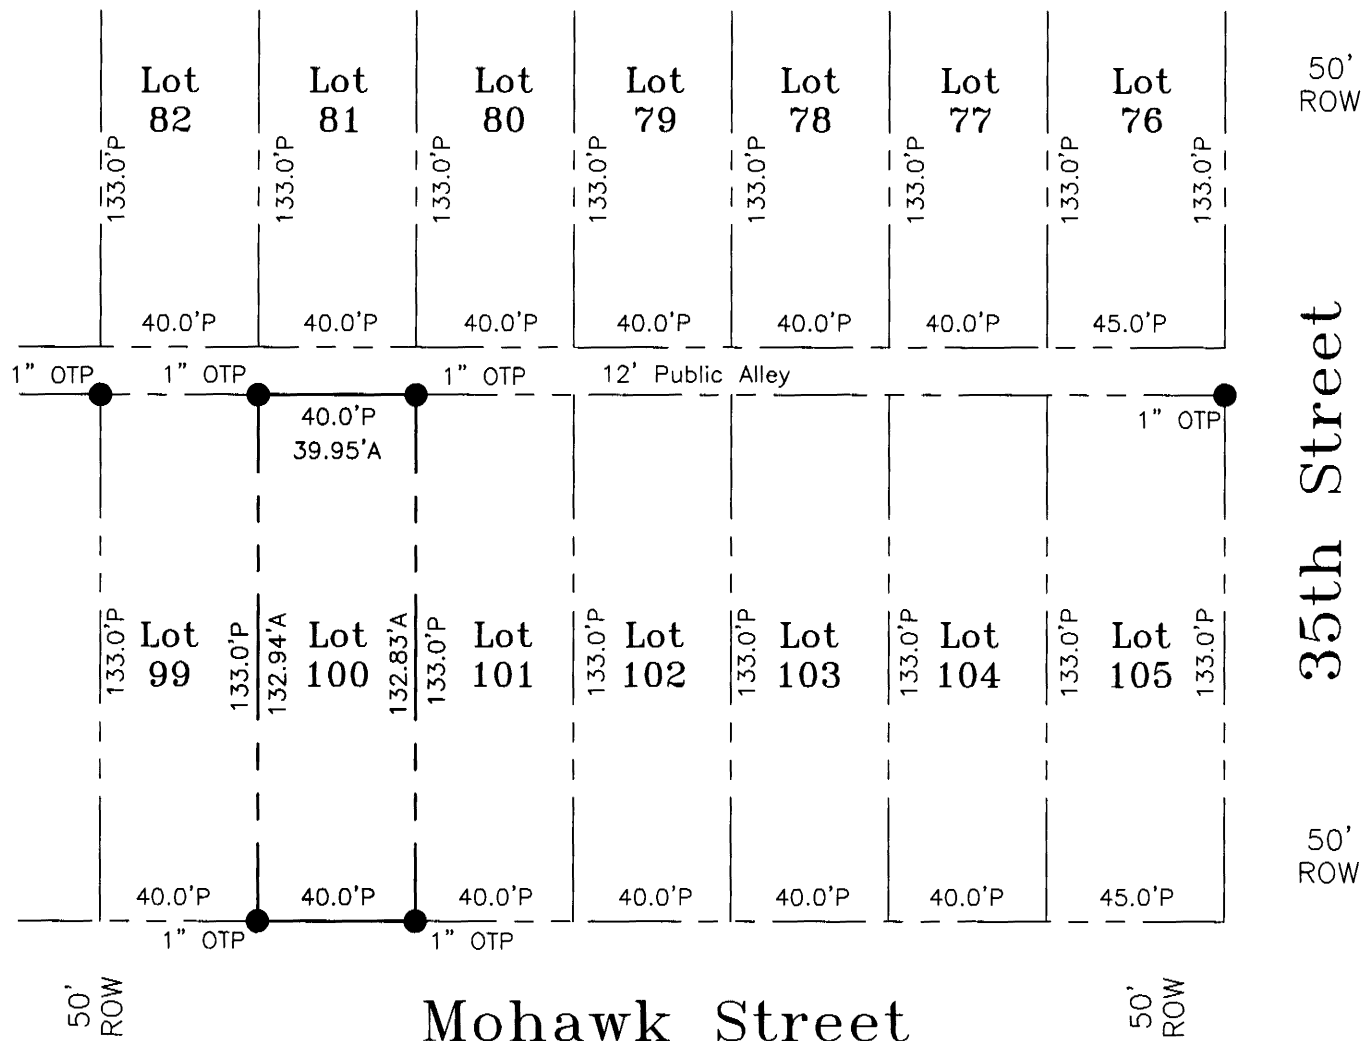

LEGAL DESCRIPTION



LOT 100, BOULEVARD ADDITION TO THE CITY OF LINCOLN, LANCASTER COUNTY, NEBRASKA.

LAND SURVEYORS CERTIFICATE

THIS IS TO CERTIFY THAT THIS SURVEY WAS DONE BY THE UNDERSIGNED, THAT THE SURVEY WAS DONE ON THE GROUND IN ACCORDANCE WITH THE MOST RECENT MINIMUM STANDARDS FOR PROPERTY BOUNDARY SURVEYS, AS SET FORTH BY THE NEBRASKA STATE BOARD OF EXAMINERS FOR REGISTERED LAND SURVEYORS AND THAT THE ACCURACY SPECIFICATION AND POSITION TOLERANCE ARE IN ACCORDANCE WITH RURAL AREA SURVEYS.

DATE: 6/7/2010

THOMAS B. CATLETT

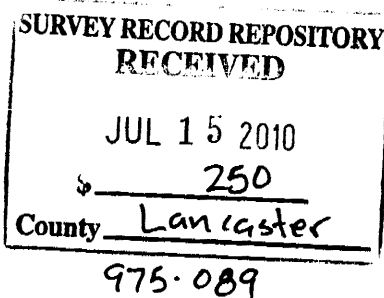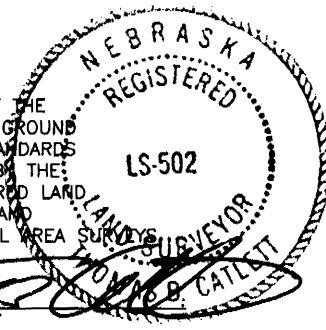

LEGEND

- - SET 5/8"x24" CAPPED REBAR UNLESS OTHERWISE NOTED
- - FOUND SURVEY POINT AS INDICATED
- △ - CALCULATED SURVEY POINT
- CTP - CRIMPED TOP PIPE
- OTP - OPEN TOP PIPE
- M - MEASURED DISTANCE
- C - CALCULATED DISTANCE
- P - PLAT DISTANCE
- R - RECORDED DISTANCE
- BOUNDARY LINE

Boundary Drawing  
for Amy Hurst  
3414 Mohawk St.  
Lincoln, Nebraska

**CATLETT LAND SURVEYING**  
Thomas B. Catlett LS 502  
7560 Greycliff Drive, Lincoln, Nebraska  
Cell: 402.217.5816 Fax: 402.261.4732  
t.catlett@hotmail.com



Drawn By: TC  
Checked By: PC  
Filed By: TC/PC  
Date: 6/07/2010  
Job #: 3414 MOHAWK  
Scale: 1" = 50'  
Sheet 1 of 1